



Indiana Department of Environmental Management
Office of Water Quality
Wetlands Section

Publication Date:
April 28, 2009

IDEM ID Number:
2009-186-49-JPS-A

Closing Date:
May 19, 2009

Corps of Engineers ID Number:
Not Available

PUBLIC NOTICE

To all interested parties:

This letter shall serve as a formal notice of the receipt of an application for **Section 401 Water Quality Certification** by the Indiana Department of Environmental Management (IDEM). The purpose of the notice is to inform the public of active applications submitted for water quality certification under Section 401 of the Clean Water Act (33 U.S.C. § 1341) and to solicit comments and information on any impacts to water quality related to the proposed project. IDEM will evaluate whether the project complies with Indiana's water quality standards as set forth at 327 IAC 2.

-
- | | | | |
|----------------------|---|------------------|--|
| 1. Applicant: | Mr. Richard L. Phillabaum
Indiana Department of Transportation
100 North Senate Avenue, Room N642
Indianapolis, IN 46204 | 2. Agent: | Mr. Trevor Wieseke
RW Armstrong
Union Station / 300 S. Meridian Street
Indianapolis, IN 46225 |
|----------------------|---|------------------|--|
-
- 3. Project location:** Sections 13, 24 & 25, Township 16 North, Range 4 East, Indianapolis East Quad.
Section 30, Township 16 North, Range 5 East, Indianapolis East Quad.
The project is located at the Interchange of I-465 and I-70 approximately 6.25 miles east on I-70 from downtown Indianapolis
- 4. Affected waterbody:** Unnamed Tributary of Pleasant Run Creek and South Branch of Pleasant Run Creek
- 5. Project Description:** The applicant proposes to extend the culvert currently carrying I-465 over the Unnamed Tributary of Pleasant Run Creek to the east with 54.31 feet of 5.91 ft corrugated metal pipe. The elevation, slope and skew of the extension will match that of the existing structure. The applicant also proposes to extend the culvert currently carrying I-465 over the South Branch of Pleasant Run Creek to the east with 21.29 feet with 10.5 ft by 6 ft precast four-sided reinforced concrete box extension and 5.57 cubic yards of riprap will be placed at the entrance of the culvert. The elevation, slope and skew of the extension will match that of the existing structure. No compensatory mitigation is proposed.
-
- Comment period:** Any person or entity who wishes to submit comments or information relevant to the aforementioned project may do so by the closing date noted above. Only comments or information related to water quality or potential impacts of the project on water quality can be considered by IDEM in the water quality certification review process.
- Public Hearing:** Any person may submit a written request that a public hearing be held to consider issues related to water quality in connection with the project detailed in this notice. The request for a hearing should be submitted within the comment period to be considered timely. The request should also state the reason for the public hearing as specifically as possible to assist IDEM in determining whether a public hearing is warranted.
- Questions?** Additional information may be obtained from Mr. Jared Sanders, Project Manager, at 317-234-6352. Please address all correspondence to the project manager and reference the IDEM project identification number listed on this notice. Indicate if you wish to receive a copy of IDEM's final decision. Written comments and inquiries may be forwarded to -

Indiana Department of Environmental Management
100 North Senate Avenue
MC65-42 WQS IGCN 1255
Indianapolis, Indiana 46204-2251
FAX: 317/232-8406

Project Location Map
USGS 7.5 Quadrangle Map –
Indianapolis East, IN

Project Area


Interchange Modification Project
I-465 at I-70
Indianapolis, Marion County, Indiana
Project No. ST-465-4 (OJZ)
Des. No. 0066810

0 2000 4000 ft

Project Area

**Interchange Modification Project
I-465 at I-70
Indianapolis, Marion County, Indiana
Project No. ST-465-4 (OJZ)
Des. No. 0066810**

0 2000 4000 ft

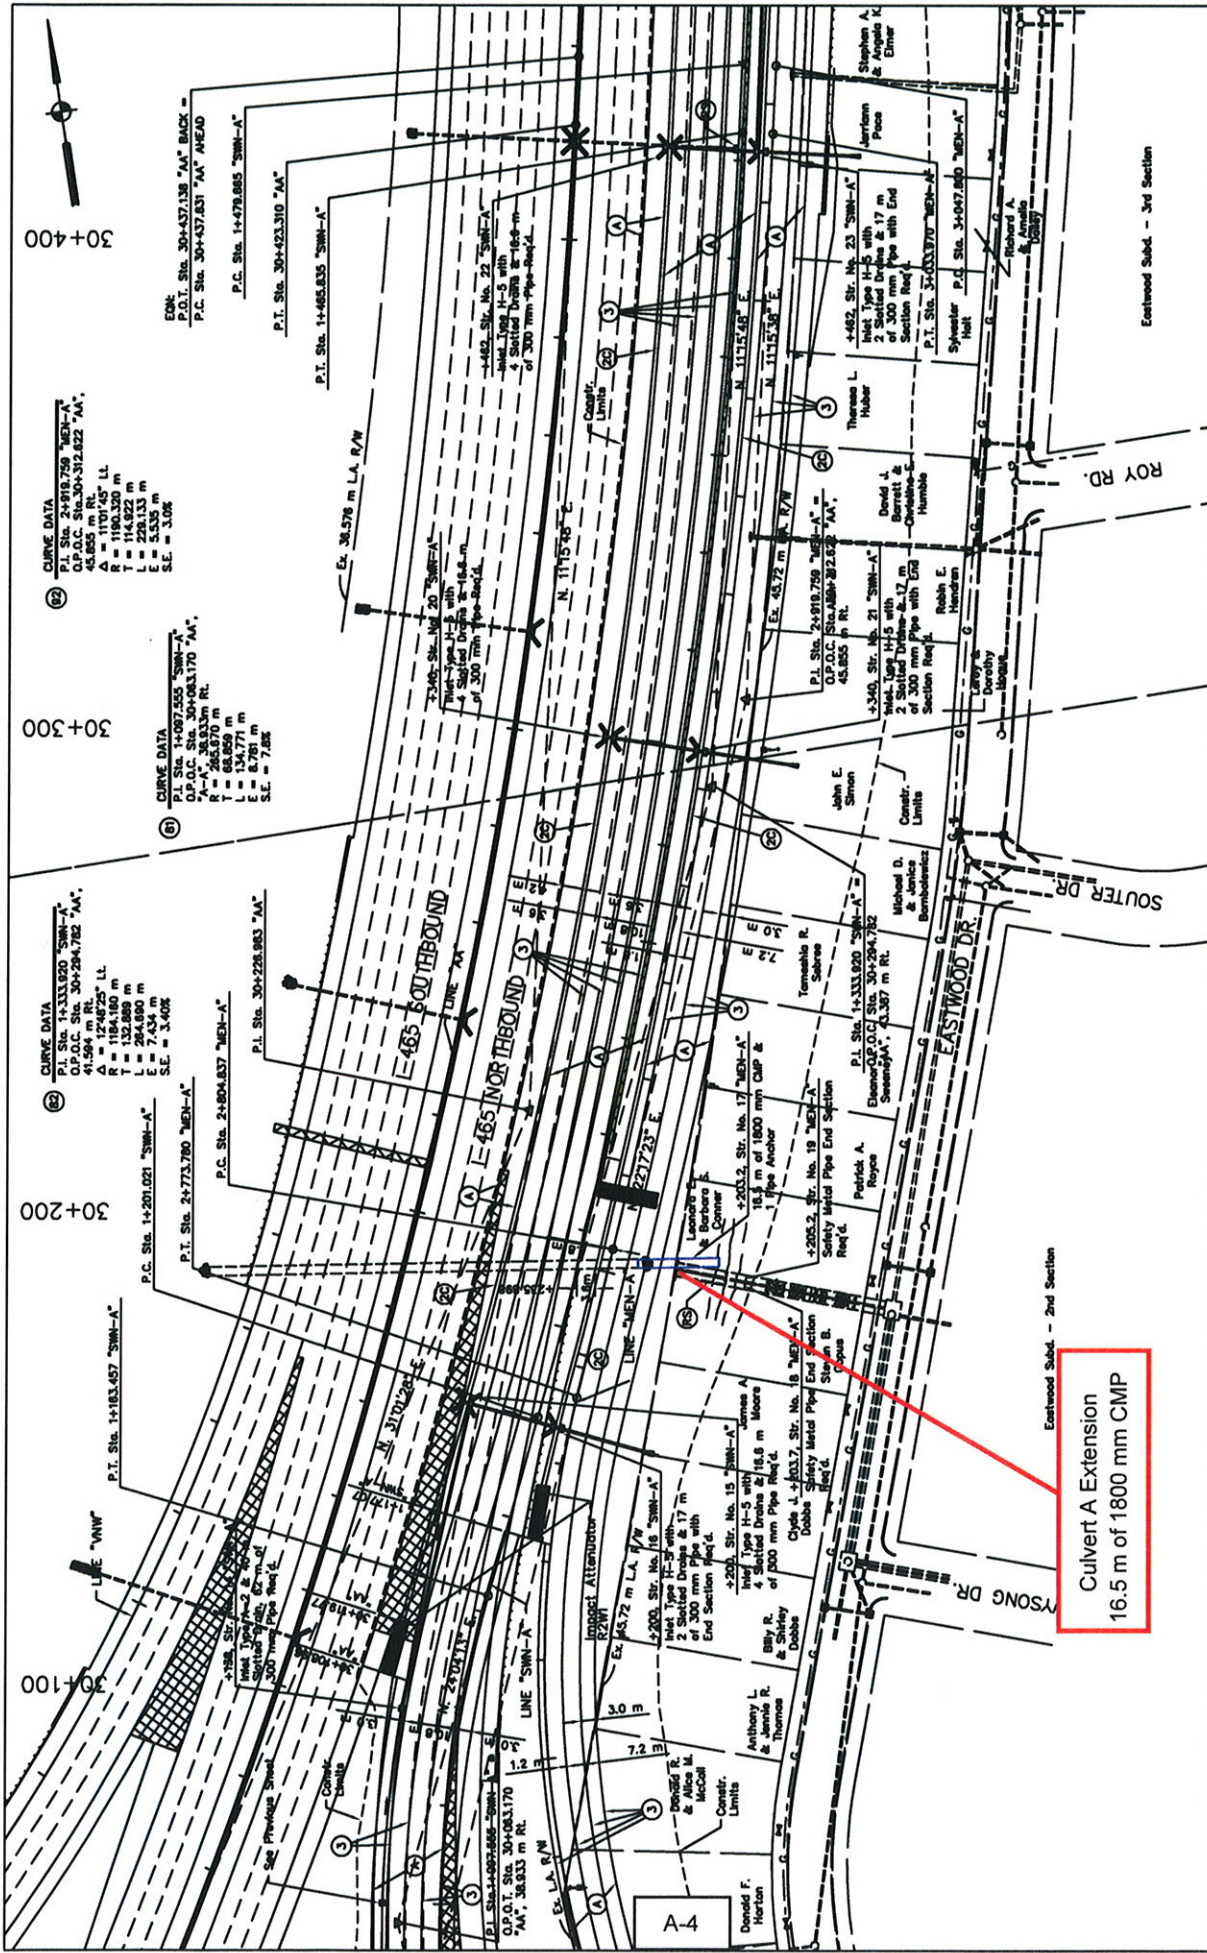

INDIANA DEPARTMENT OF TRANSPORTATION		HORIZONTAL SCALE 1" = 500' VERTICAL SCALE 1" = 10' SHEET NO. 0046610
LINE "AA" CONSTRUCTION DETAILS		SHEET NO. 47 PROJECT ST-465-1(042)
RECOMMENDED FOR APPROVAL DESIGNED BY CHECKED BY IN CHARGE DATE	DESIGNED BY CHECKED BY IN CHARGE DATE	REVISIONS NO. DESCRIPTION 1 Remove Structure 2 Remove Guardrail 3 Remove Overhead Sign
3 Longitudinal Joint 350 mm OC/DA PCP w/ Random steel joints	24 840 mm Concrete Reinforced 20 1145 mm Anchored Concrete Barrier Wall 25 1145 mm Concrete Bridge Railing	




30+500

DATA (DS=110)
1. 1+718.658 SWN-A =
Sta. 30+670.750 "AA",
m R/L
65716" Lt.
42.078 m
5.086 m
6.745 m
108 m
4.20%

P.J. Sta. 30+638.105 "AA"

All R/W described from Line "AA" This Sheet

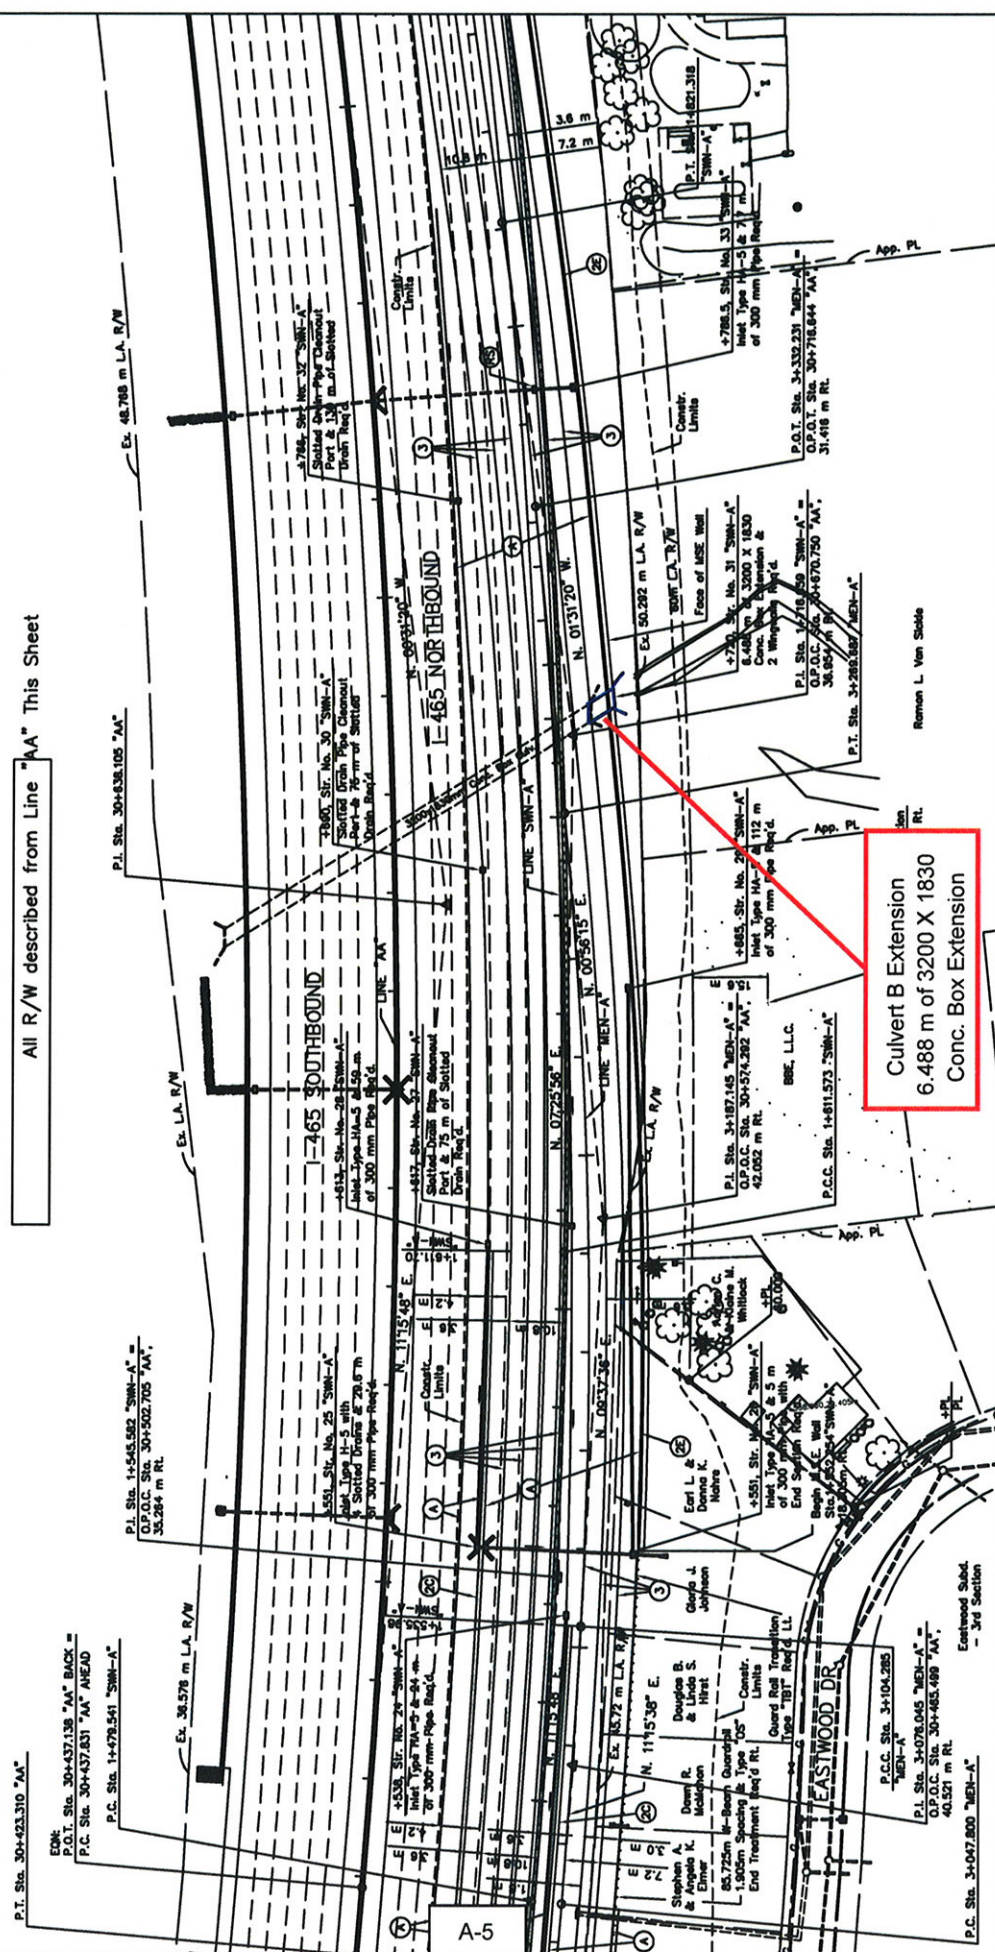

Culvert B Extension
6.488 m of 3200 X 1830
Conc. Box Extension

[illegible]